


2340 Shepler Church Ave SW
Canton, OH 44706
234.458.0990

OHIO • CALIFORNIA
COLORADO • INDIANA
OKLAHOMA

Location:
FLOWER CHILD
1900 CROCKER ROAD
WESTLAKE, OH 44145

Revision:
1)PM:08.07.26:Update C/D to painted letters

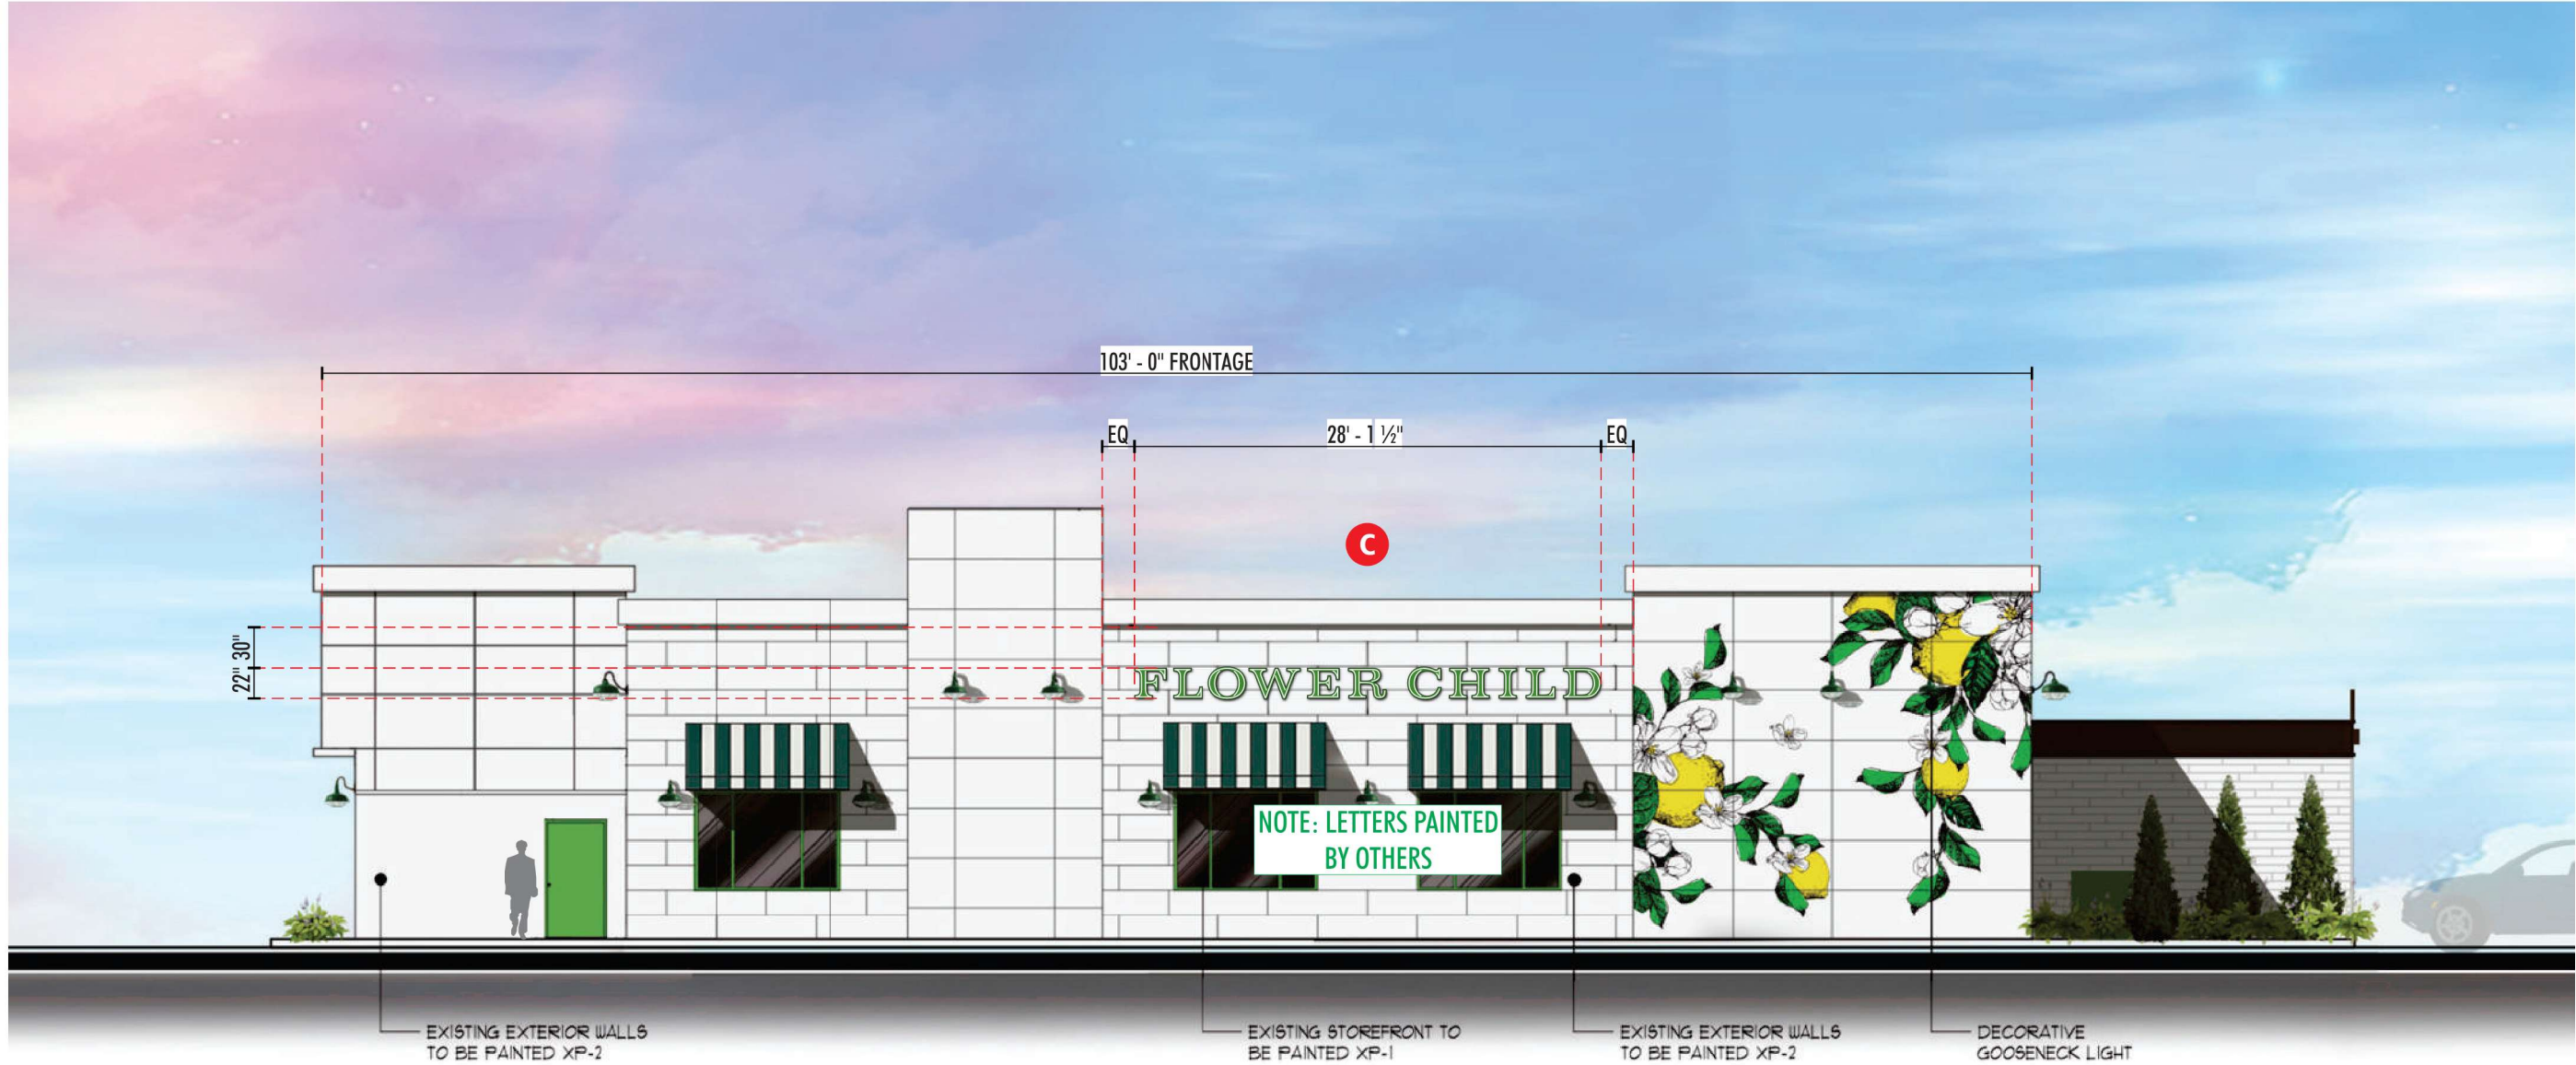

1

WEST ELEVATION
SCALE: 3/32" = 1' - 0"

NOTE: MURALS BY OTHERS

SQ. FT. ALLOWED: 1.5 SF PER 1 LF
NTE 75 SF
103 x 1.5 = 154 SF

- ☐ Approved
☐ Approved as Noted
☐ Revise & Resubmit

Drawing No: 26-0313-R01

Date: 08.06.2026 PM

Page No: 1.02

This is an original unpublished drawing created by First & Main Signs. It is submitted for your personal use in conjunction with a project being planned for you by First & Main Signs. It is not to be shown to anyone outside your organization, nor is it to be used, reproduced, copied or exhibited in any fashion without written permission from First & Main Signs.